# VAR PLN2016-0067
# 1st Light Energy
## AREA MAP

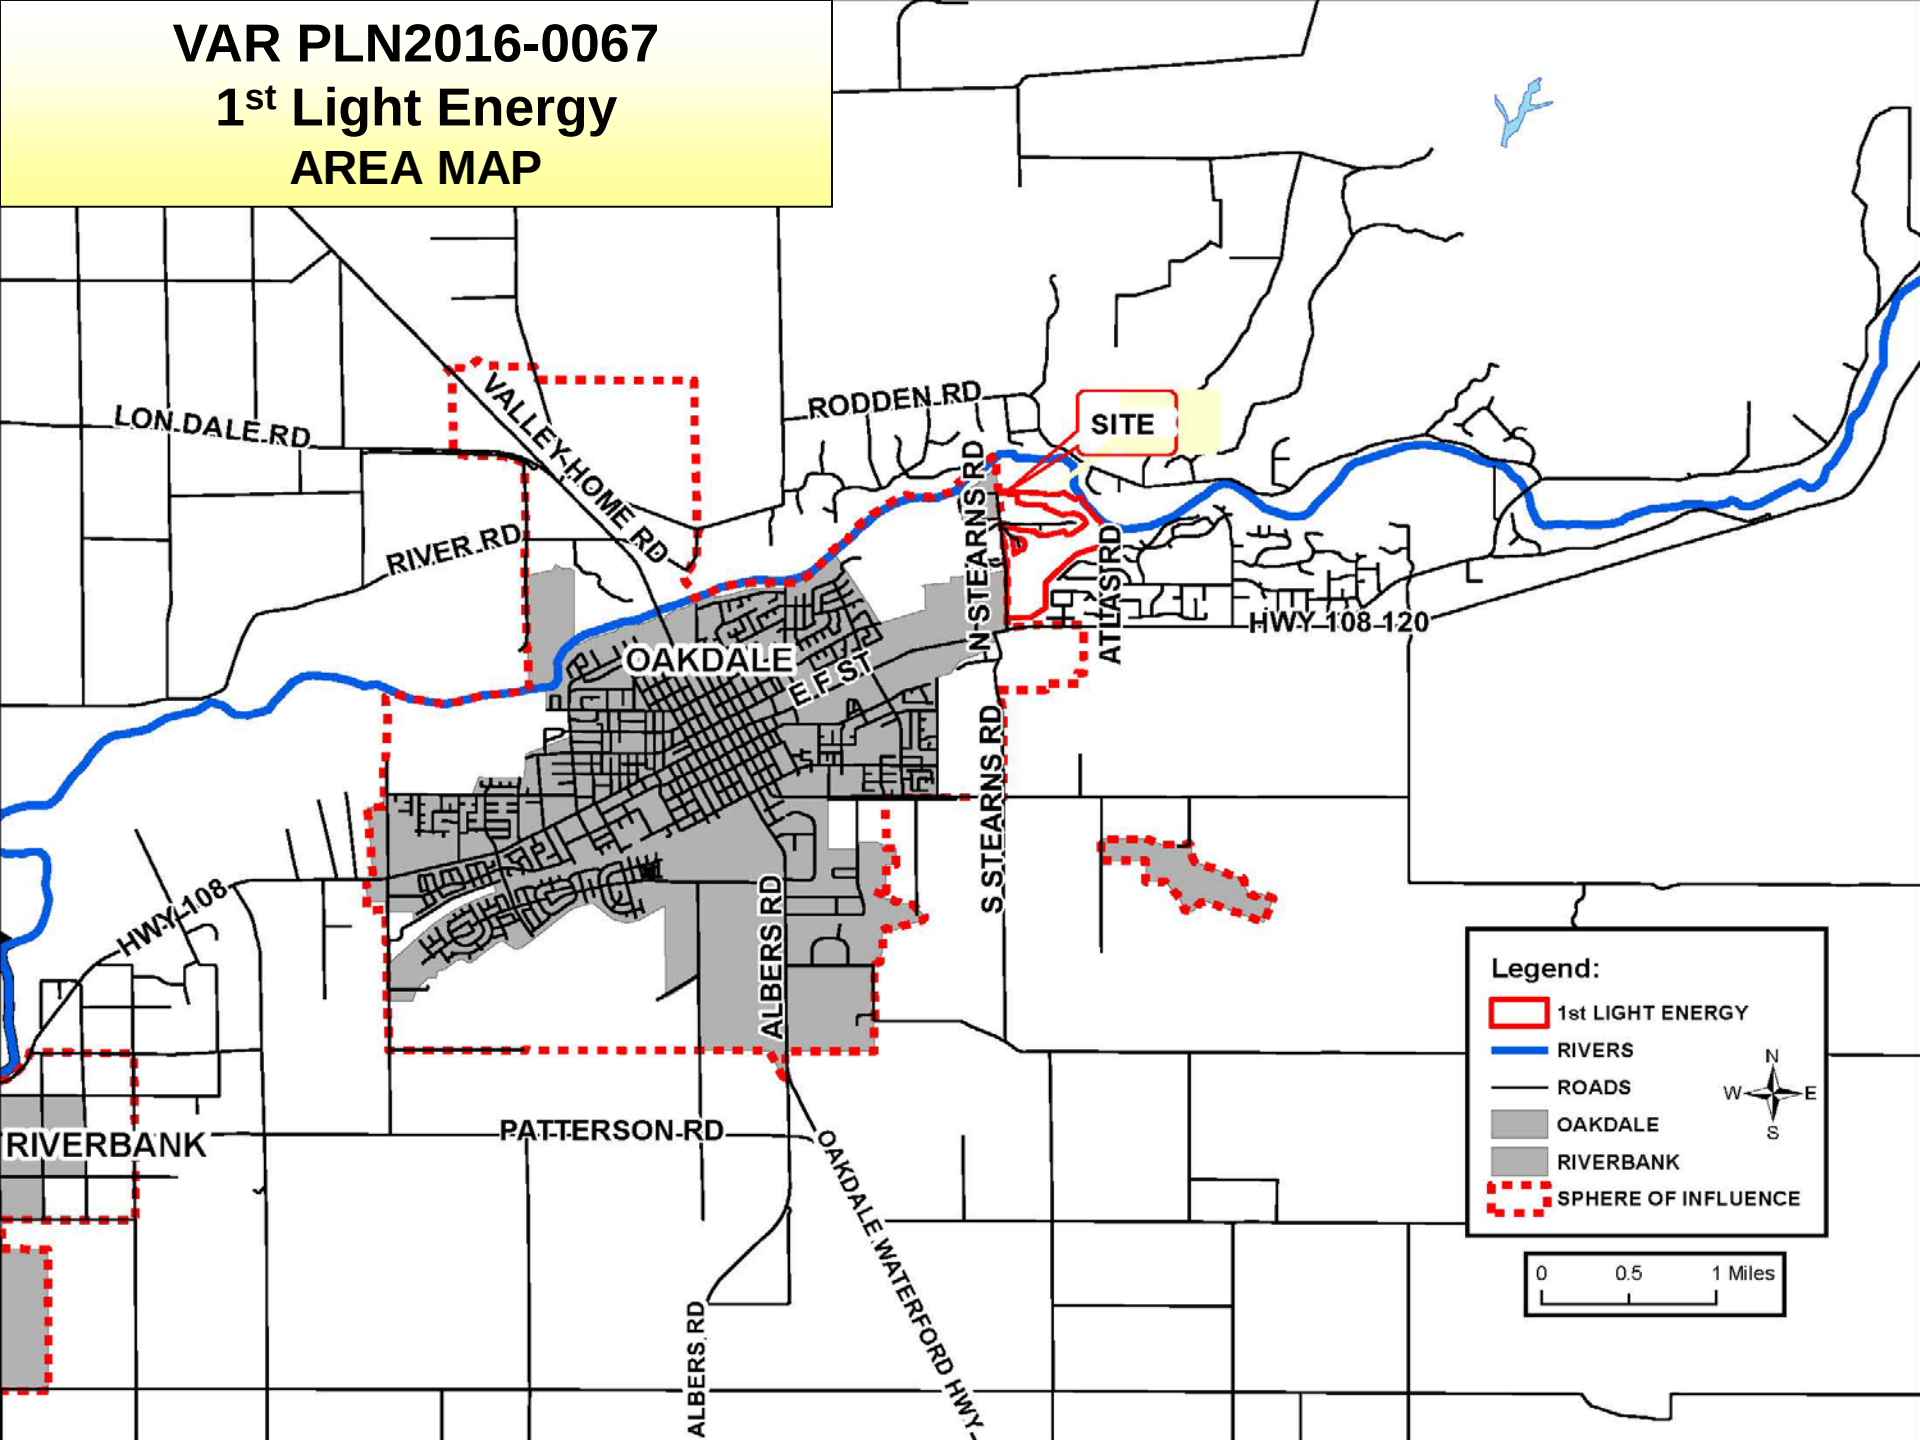

# VAR PLN2016-0067
# 1st Light Energy
# GENERAL PLAN MAP

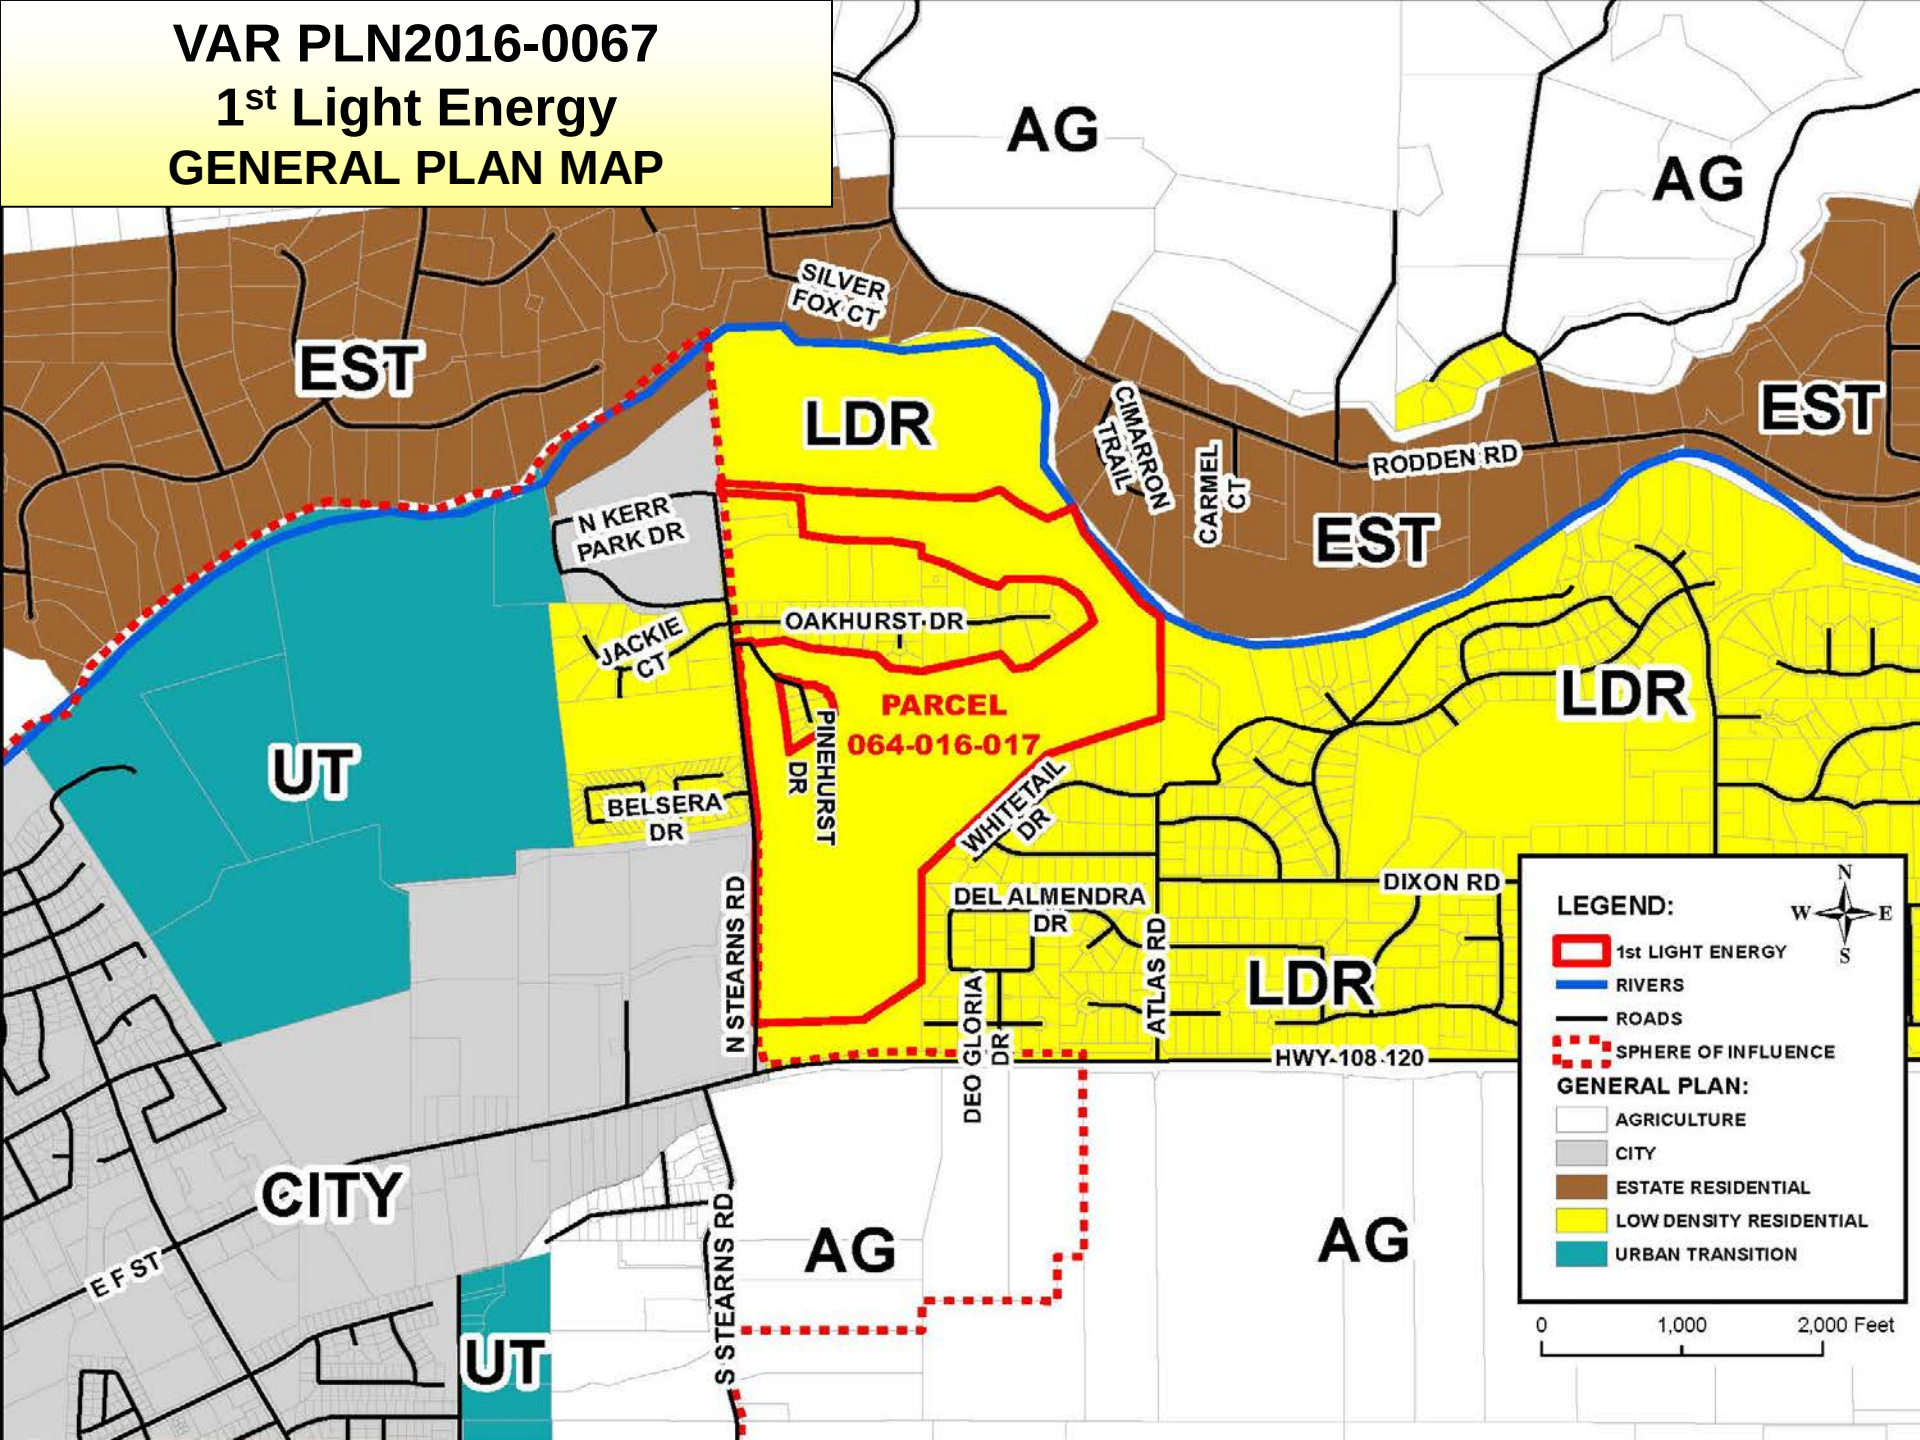

# VAR PLN2016-0067
# 1st Light Energy
## ZONING MAP

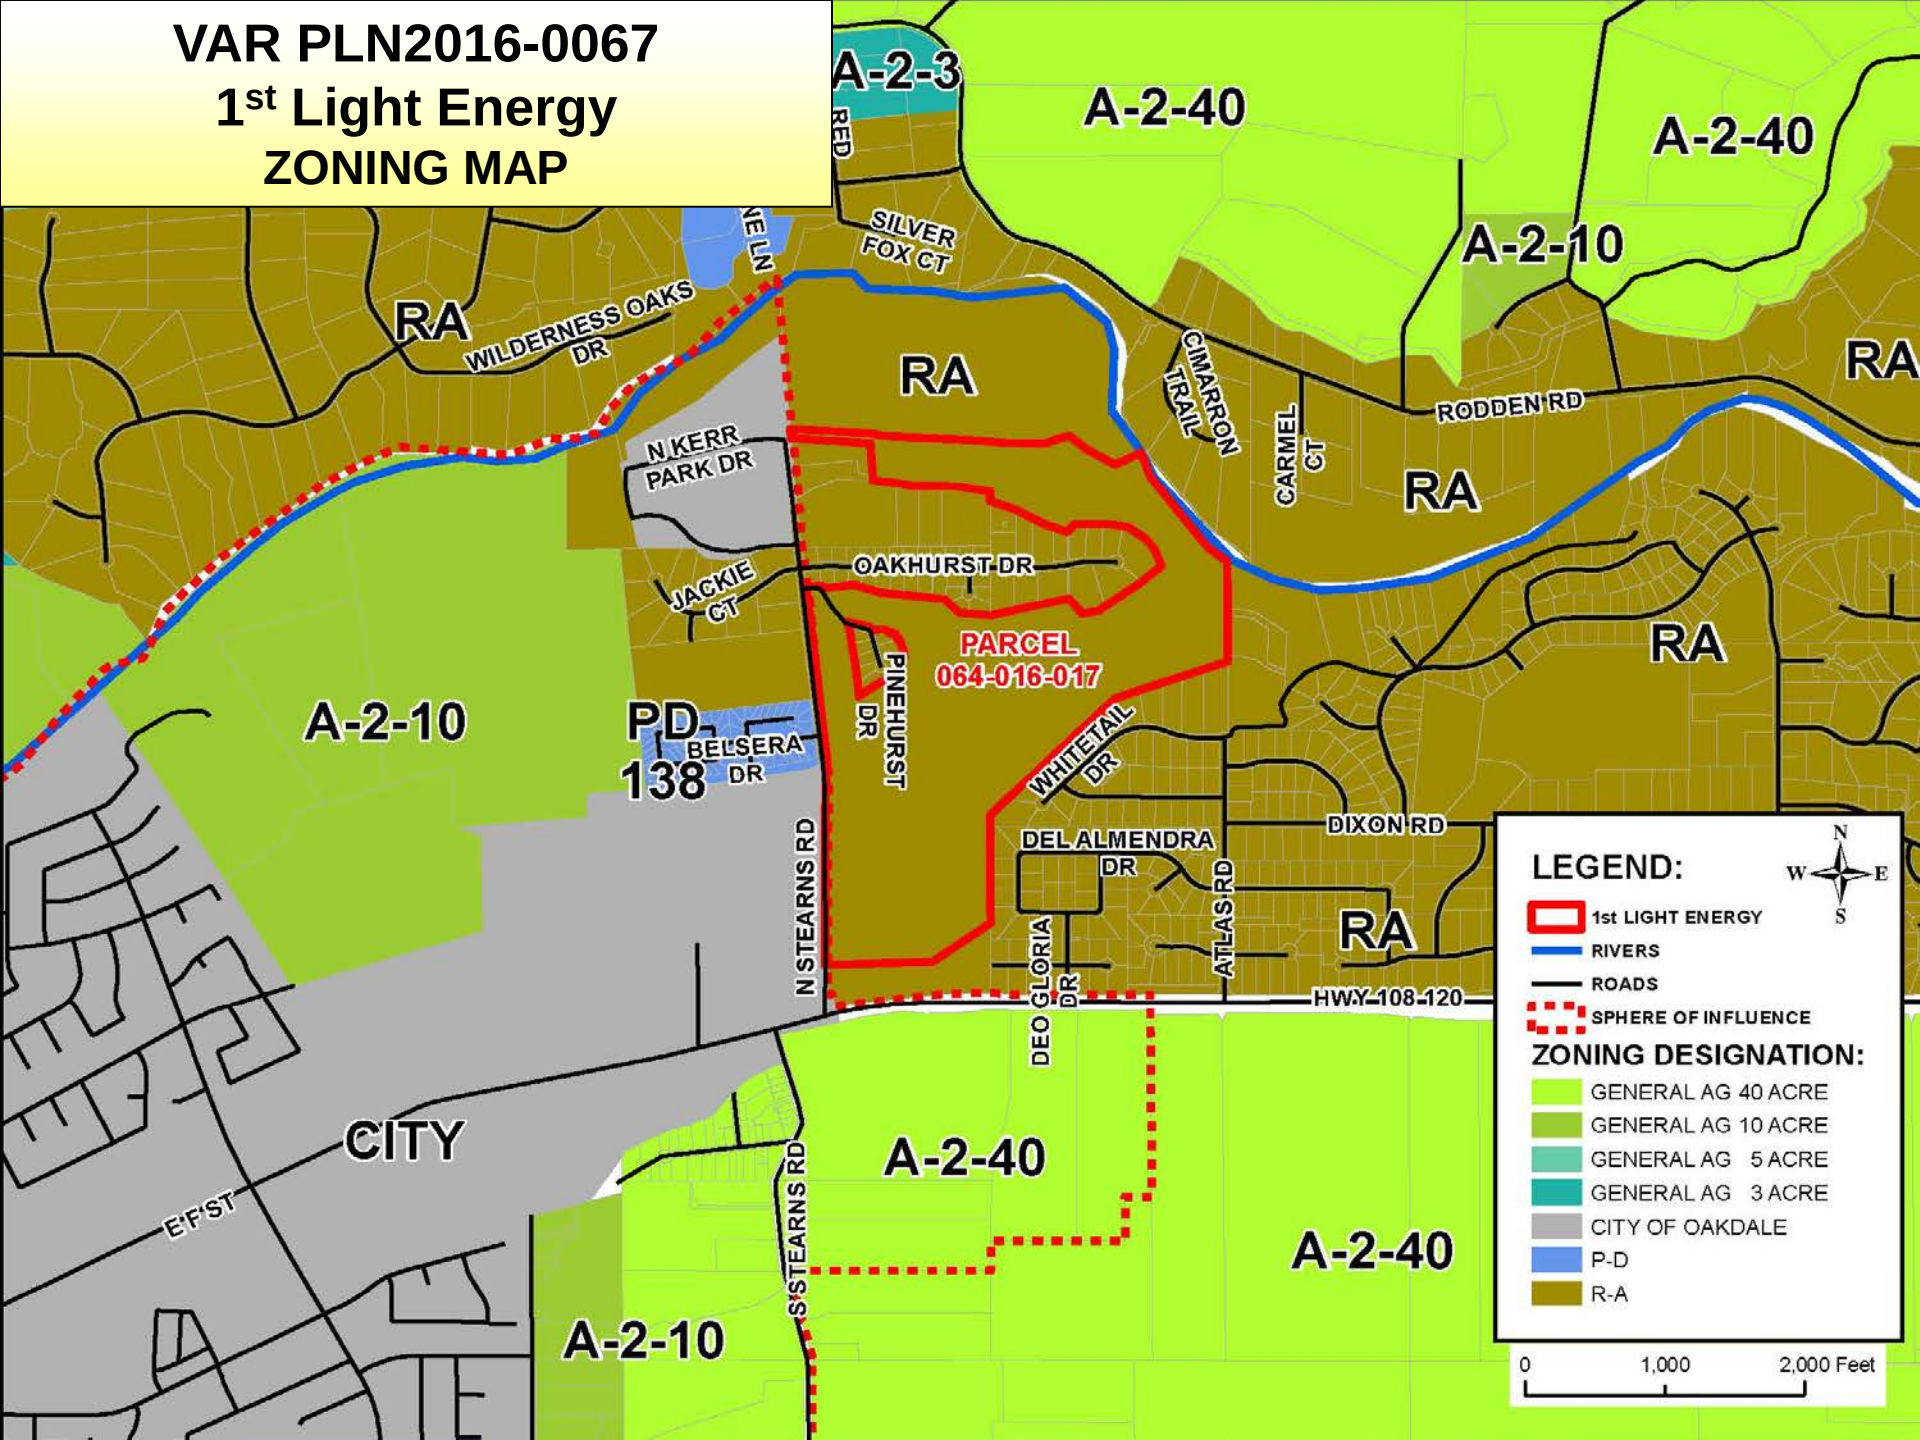

# VAR PLN2016-0067
# 1st Light Energy
## ACREAGE MAP

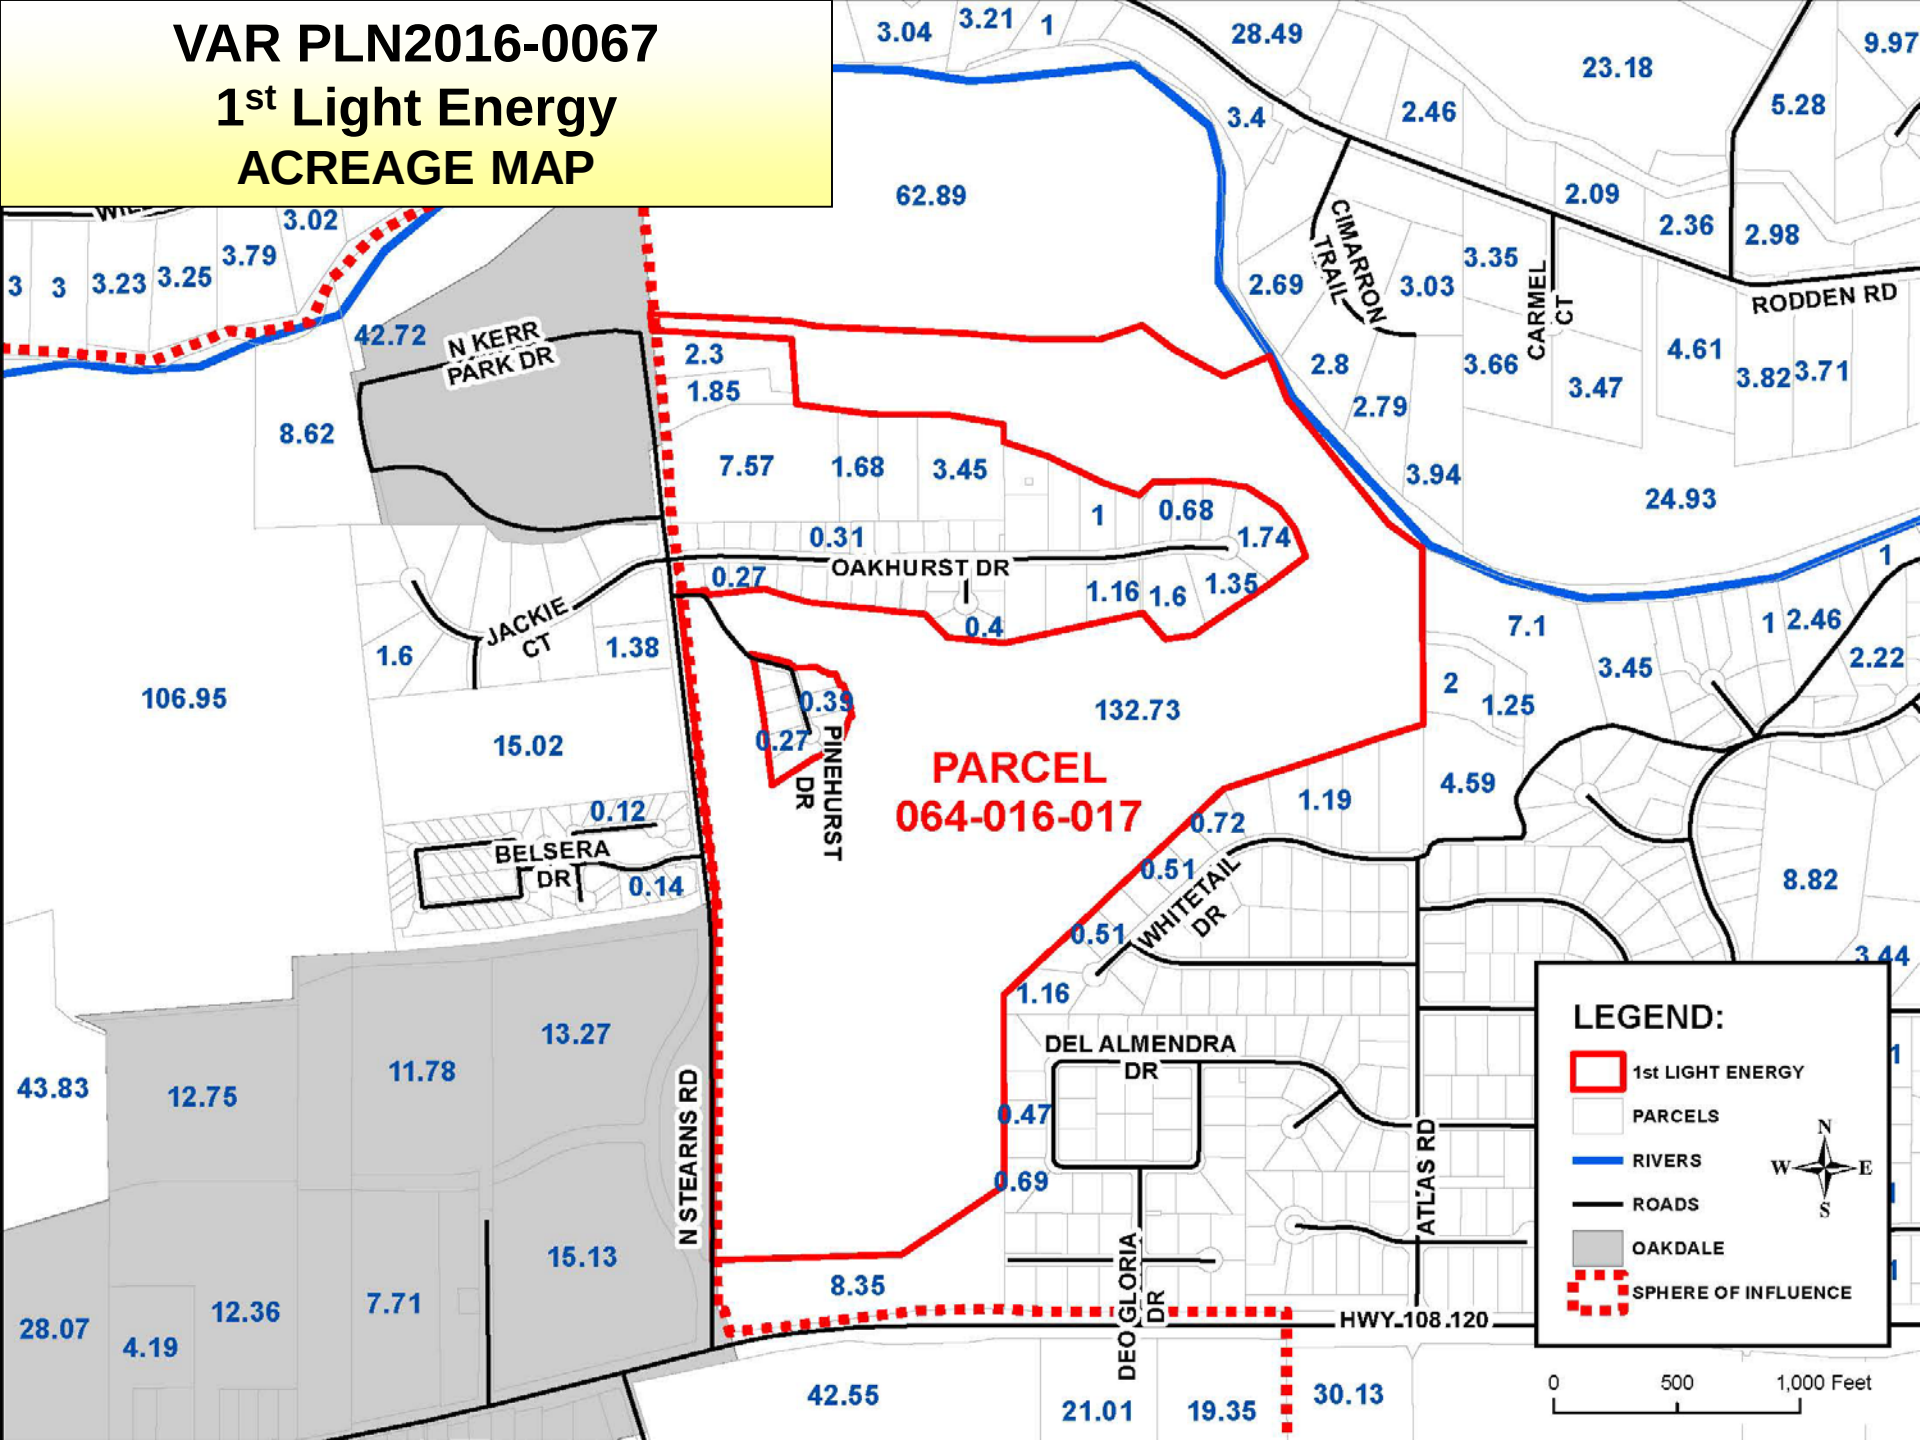

# VAR PLN2016-0067
# 1st Light Energy
# 2015 COUNTY AERIAL

# VAR PLN2016-0067
# 1st Light Energy
# 2015 COUNTY AERIAL

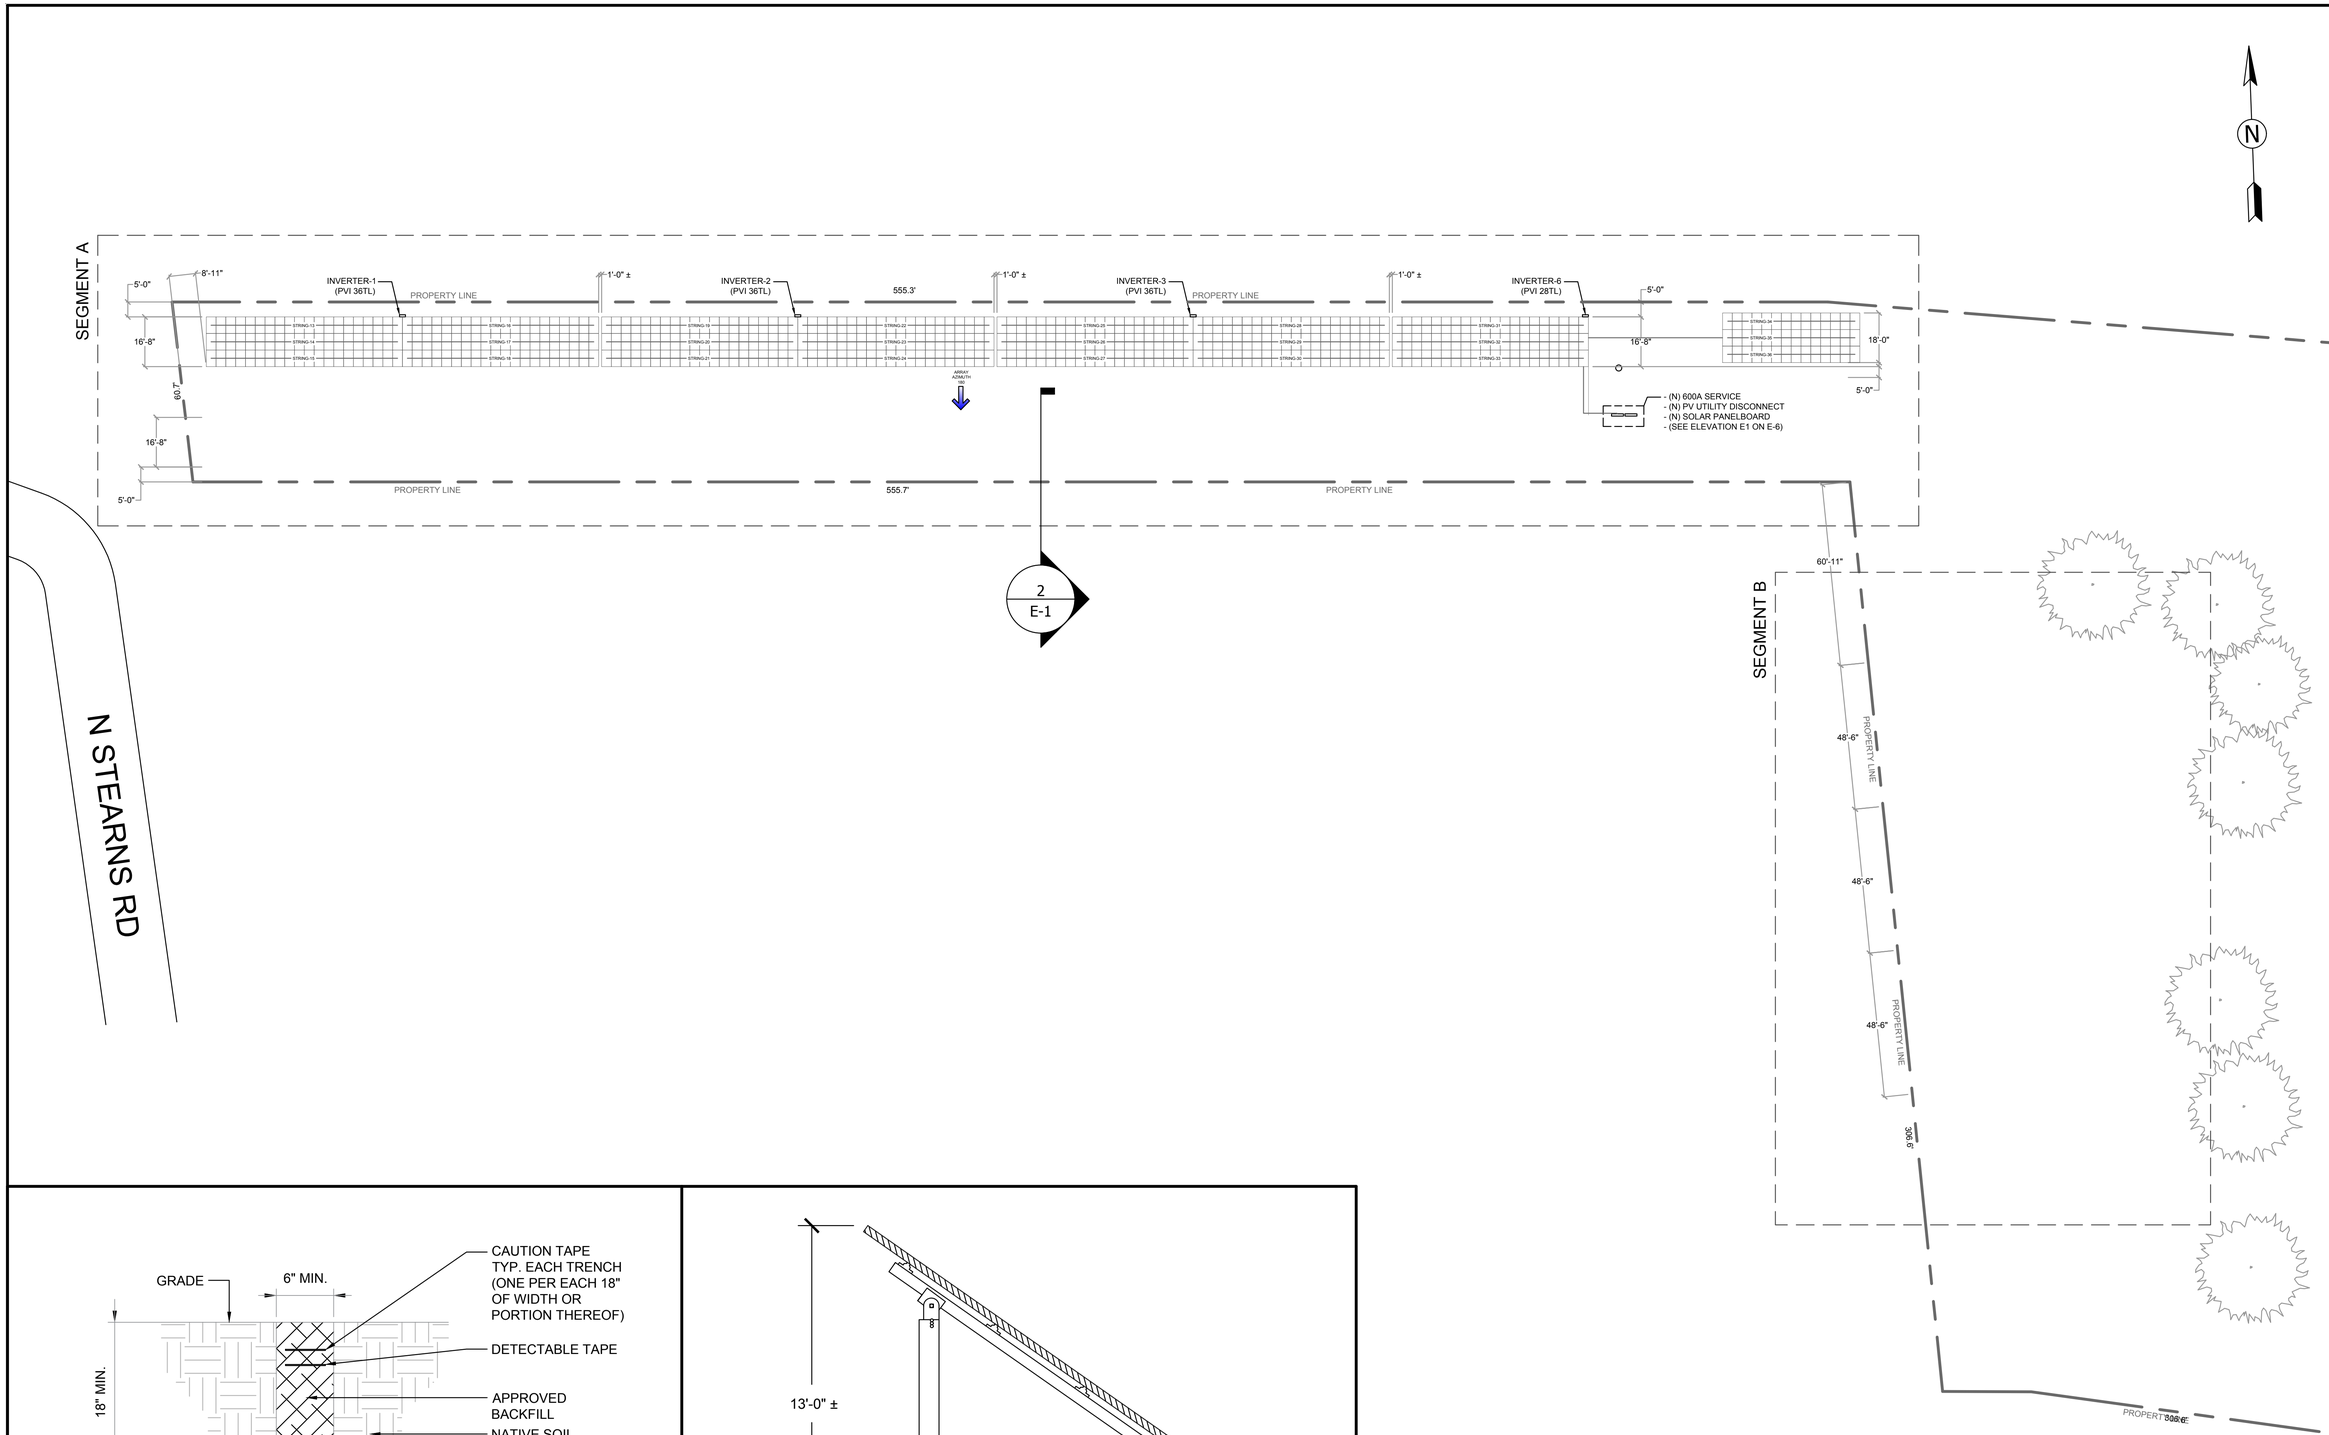


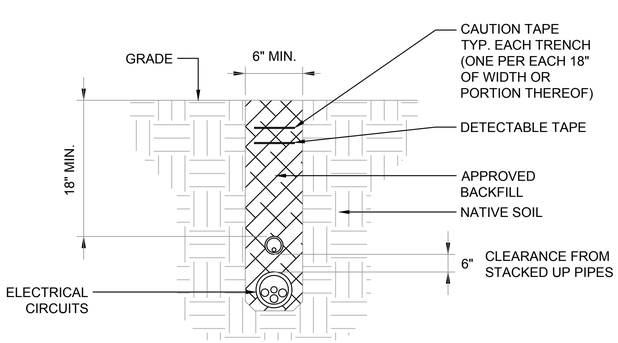


1 FEEDER BURIED CONDUIT SECTION

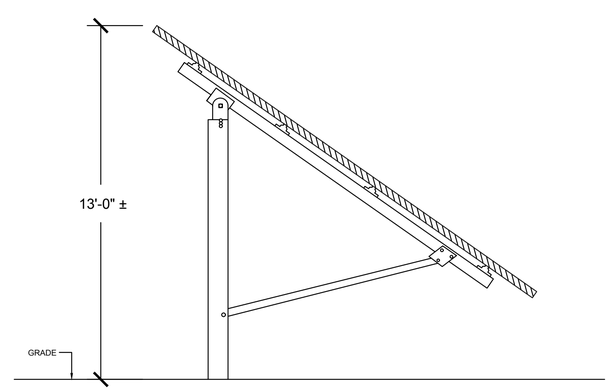


2 ARRAY SECTION

1ST Light Energy
1869 MOFFAT BOULEVARD
MANTECA, CA 95336
T. (209) 824-5500 F. (209) 824-5575
WWW.1STLIGHTENERGY.COM

| # | REVISION DESCRIPTION | DATE | BY | CH |
|---|---|---|---|---|
| 1 | ORIGINAL AT 90 % | 4/16/14 | AG | |
| 1 | AS-BUILT | 2/11/16 | BV | |

JOB SITE ADDRESS:
243 N STEARNS RD
OAKDALE, CA 95361

OAKDALE GOLF AND COUNTRY CLUB
SIZE (DC): 140.9KW
MODULE COUNT: 462
MODULE DC RATING: 305W

SCALE: 1-2" - 1'-0"

OVERALL LAYOUT

SHEET: E-2

DATE: 10/9/2015

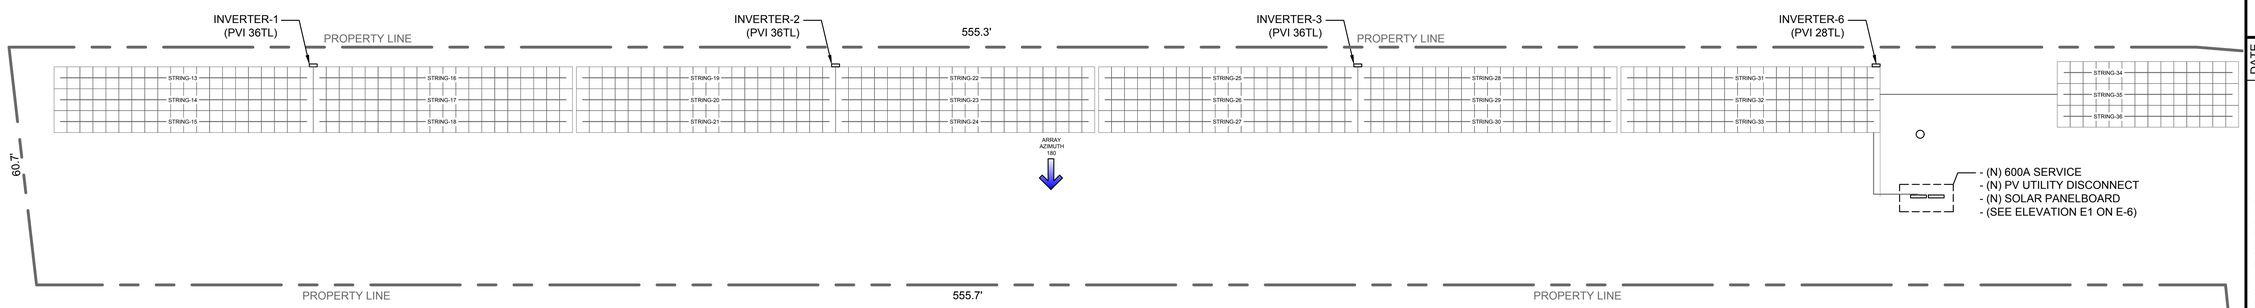


1 ELECTRICAL LAYOUT PLAN - SEGMENT A

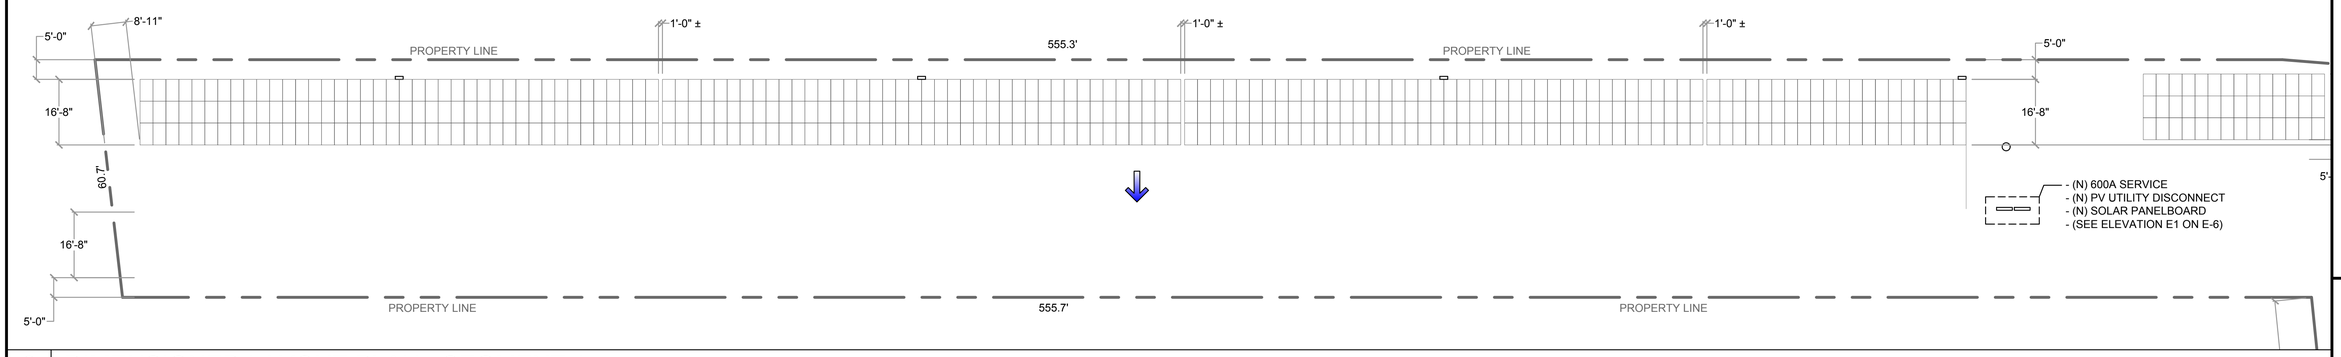


2 DIMENSIONED LAYOUT PLAN - SEGMENT A

1ST Light Energy
1869 MOFFAT BOULEVARD
MANTECA, CA 95336
T. (209) 824-5500 F. (209) 824-5575
WWW.1STLIGHTENERGY.COM

| # | REVISION DESCRIPTION | DATE | BY | CH |
|---|---|---|---|---|
| 1 | ORIGINAL AT 90 % | 4/16/14 | AG | |
| 1 | AS-BUILT | 2/11/16 | BV | |

JOB SITE ADDRESS:
243 N STEARNS RD
OAKDALE, CA 95361

OAKDALE GOLF AND COUNTRY CLUB
SIZE (DC): 140.9KW
MODULE COUNT: 462
MODULE DC RATING: 305W

SCALE: 1" = 20'-0"

DETAILED LAYOUT

SHEET: E-3

DATE: 10/9/2015